
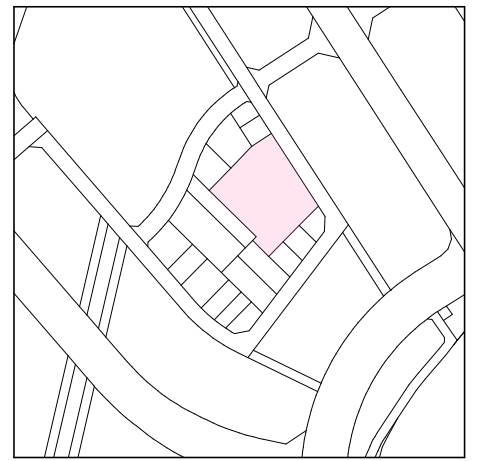
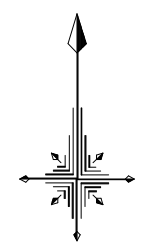


画地出来形確認測量原図

縮尺 1 : 5 0 0

令和七年七月
作成

池田測量設計株式会社
調製

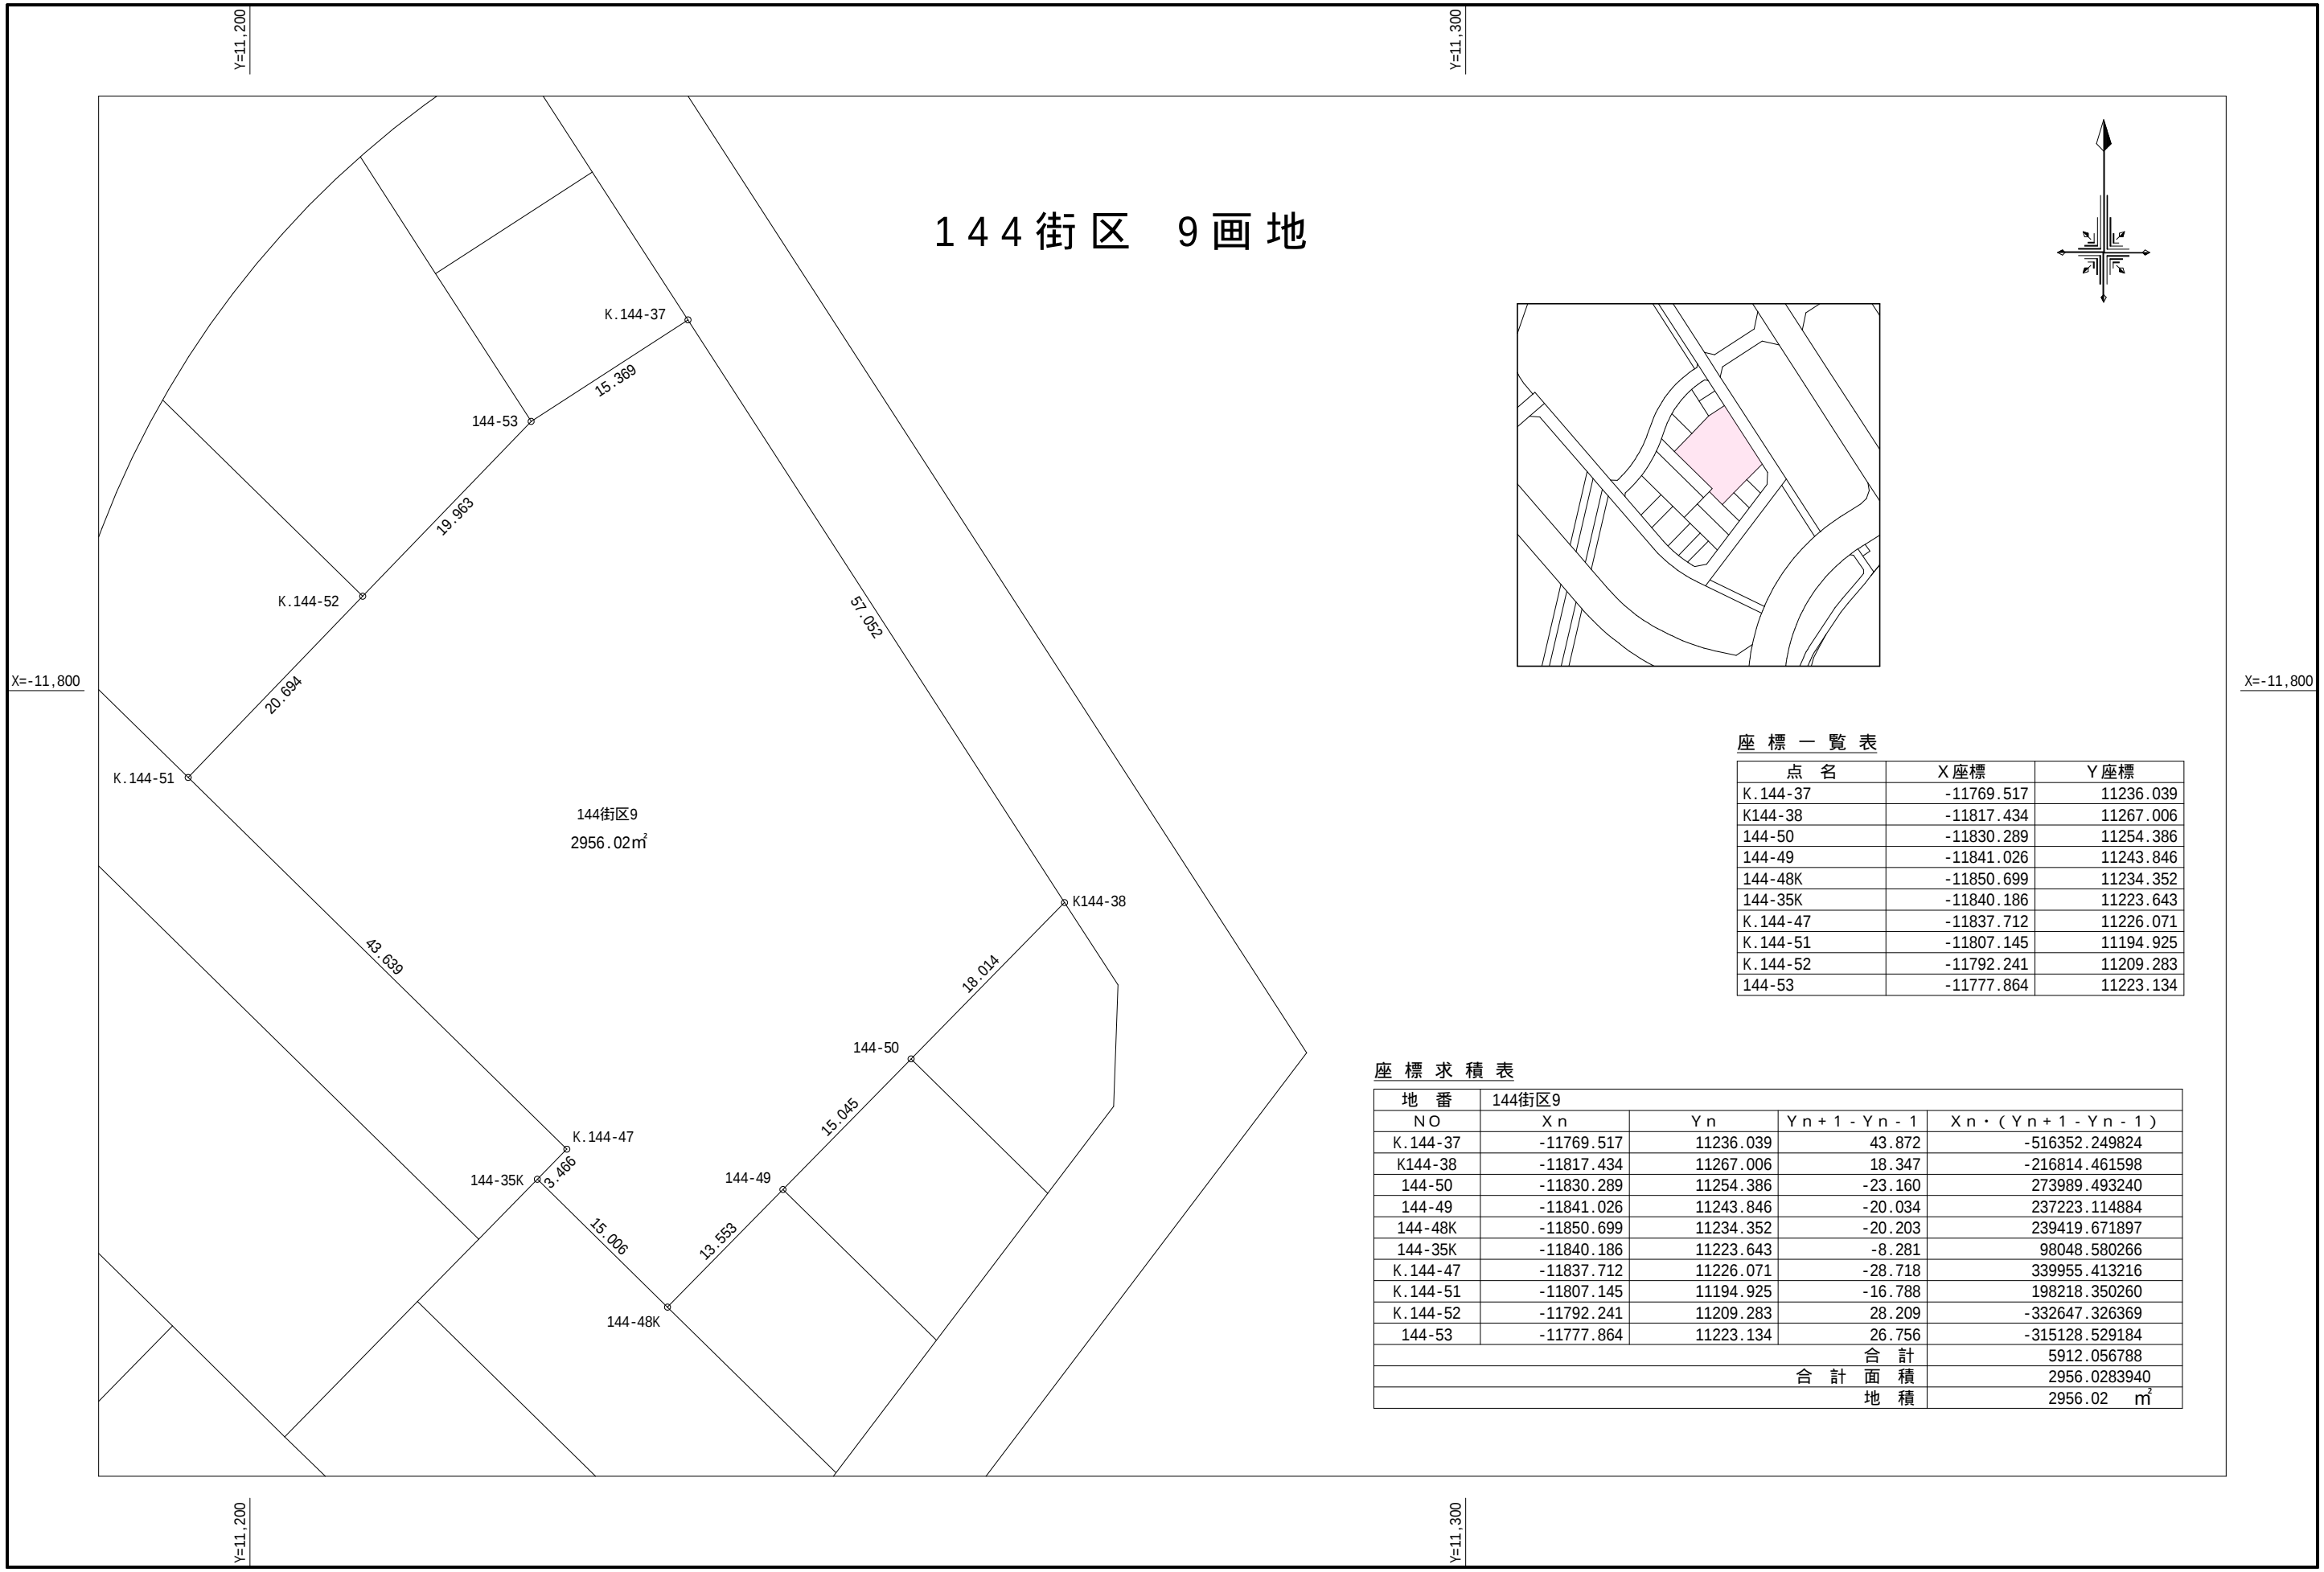

座 標 一 覧 表

点 名	X座標	Y座標
K.144-37	-11769.517	11236.039
K144-38	-11817.434	11267.006
144-50	-11830.289	11254.386
144-49	-11841.026	11243.846
144-48K	-11850.699	11234.352
144-35K	-11840.186	11223.643
K.144-47	-11837.712	11226.071
K.144-51	-11807.145	11194.925
K.144-52	-11792.241	11209.283
144-53	-11777.864	11223.134

座 標 求 積 表

地 番	144街区9			
NO	X n	Y n	Y n + 1 - Y n - 1	X n ・ (Y n + 1 - Y n - 1)
K.144-37	-11769.517	11236.039	43.872	-516352.249824
K144-38	-11817.434	11267.006	18.347	-216814.461598
144-50	-11830.289	11254.386	-23.160	273989.493240
144-49	-11841.026	11243.846	-20.034	237223.114884
144-48K	-11850.699	11234.352	-20.203	239419.671897
144-35K	-11840.186	11223.643	-8.281	98048.580266
K.144-47	-11837.712	11226.071	-28.718	339955.413216
K.144-51	-11807.145	11194.925	-16.788	198218.350260
K.144-52	-11792.241	11209.283	28.209	-332647.326369
144-53	-11777.864	11223.134	26.756	-315128.529184
		合 計		5912.056788
		合 計 面 積		2956.0283940
		地 積		2956.02 m ²